

COUNCIL ACTION FORM

SUBJECT: VACATION OF A SANITARY SEWER EASEMENT AT 610 & 700 SE 16TH STREET

BACKGROUND:

The final plat for the Menards Subdivision included an easement across 610 and 700 SE 16th Street for a sanitary sewer main extension that was anticipated to be installed as part of the new Menards store construction. However, during construction it was determined that an existing raw water main was at an elevation that prevented the sewer from being installed as planned. Therefore, the sanitary sewer main extension was relocated further to the west and a new easement was established and secured for that new sanitary sewer main location. **As a result, the previously platted sewer easement is no longer needed and can be vacated (see attached map).**


ALTERNATIVES:

1. Set the date of public hearing as November 12, 2019 to approve the vacation of the aforementioned easement at 610 & 700 SE 16th Street.
2. Reconsider the vacation of the aforementioned easement at 610 & 700 SE 16th Street.

MANAGER'S RECOMMENDED ACTION:

This sanitary sewer easement can be vacated because the sewer was installed in a different location than originally planned and therefore is no longer necessary. **Therefore, it is the recommendation of the City Manager that the City Council adopt Alternative No. 1 as noted above.**

ATTACHMENT A

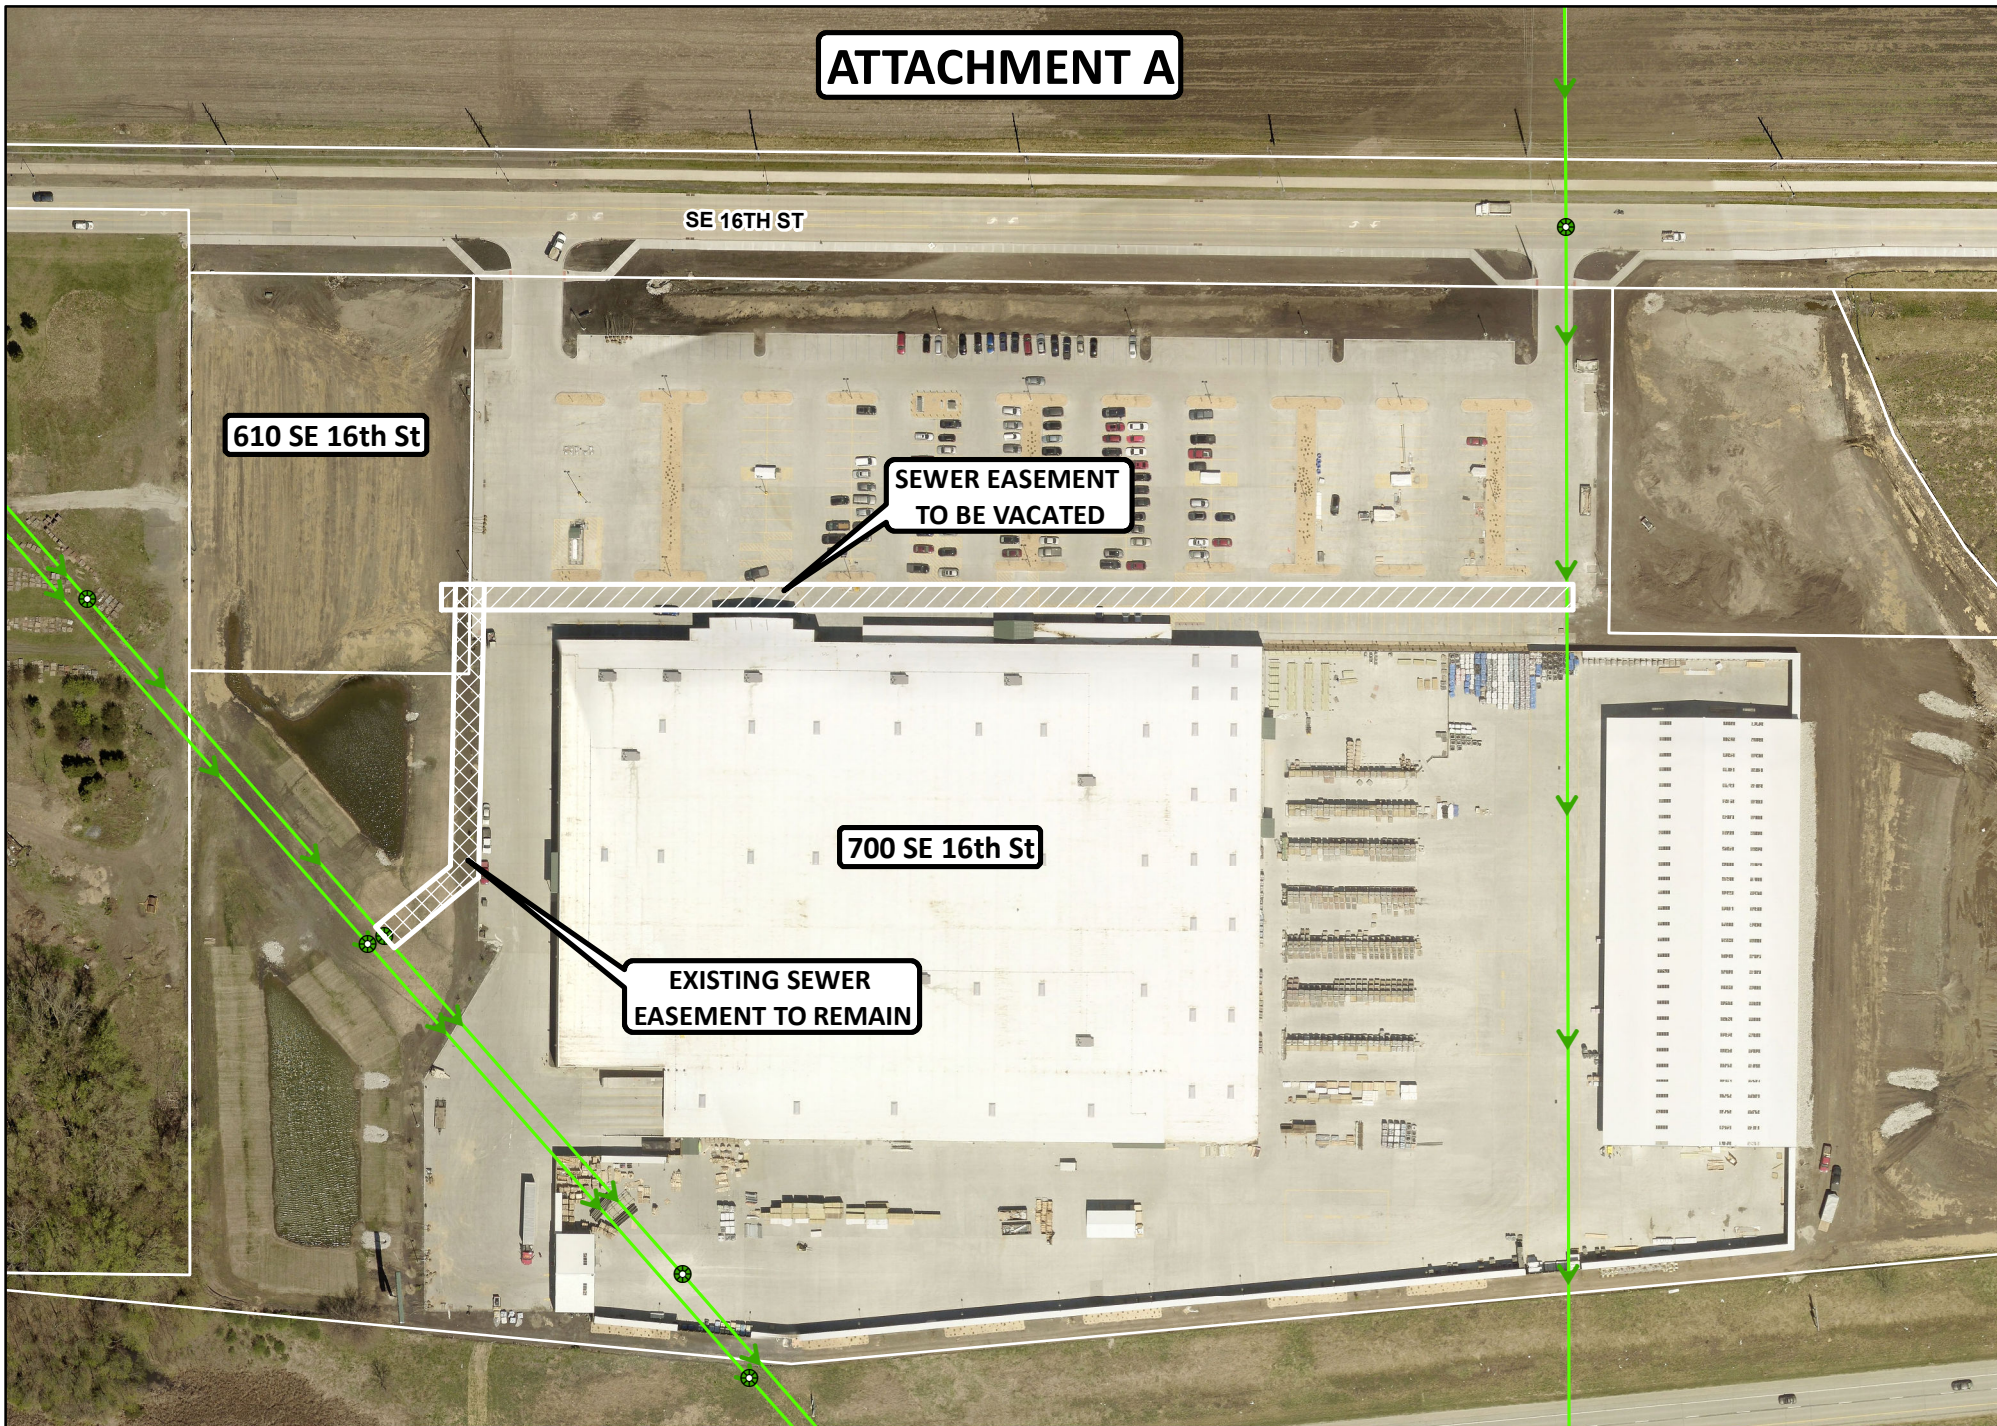

LOCATION MAP:
610 & 700 SE 16th Street
Proposed sanitary sewer easement vacation



1 inch = 150 feet
Date: 10/7/2019